



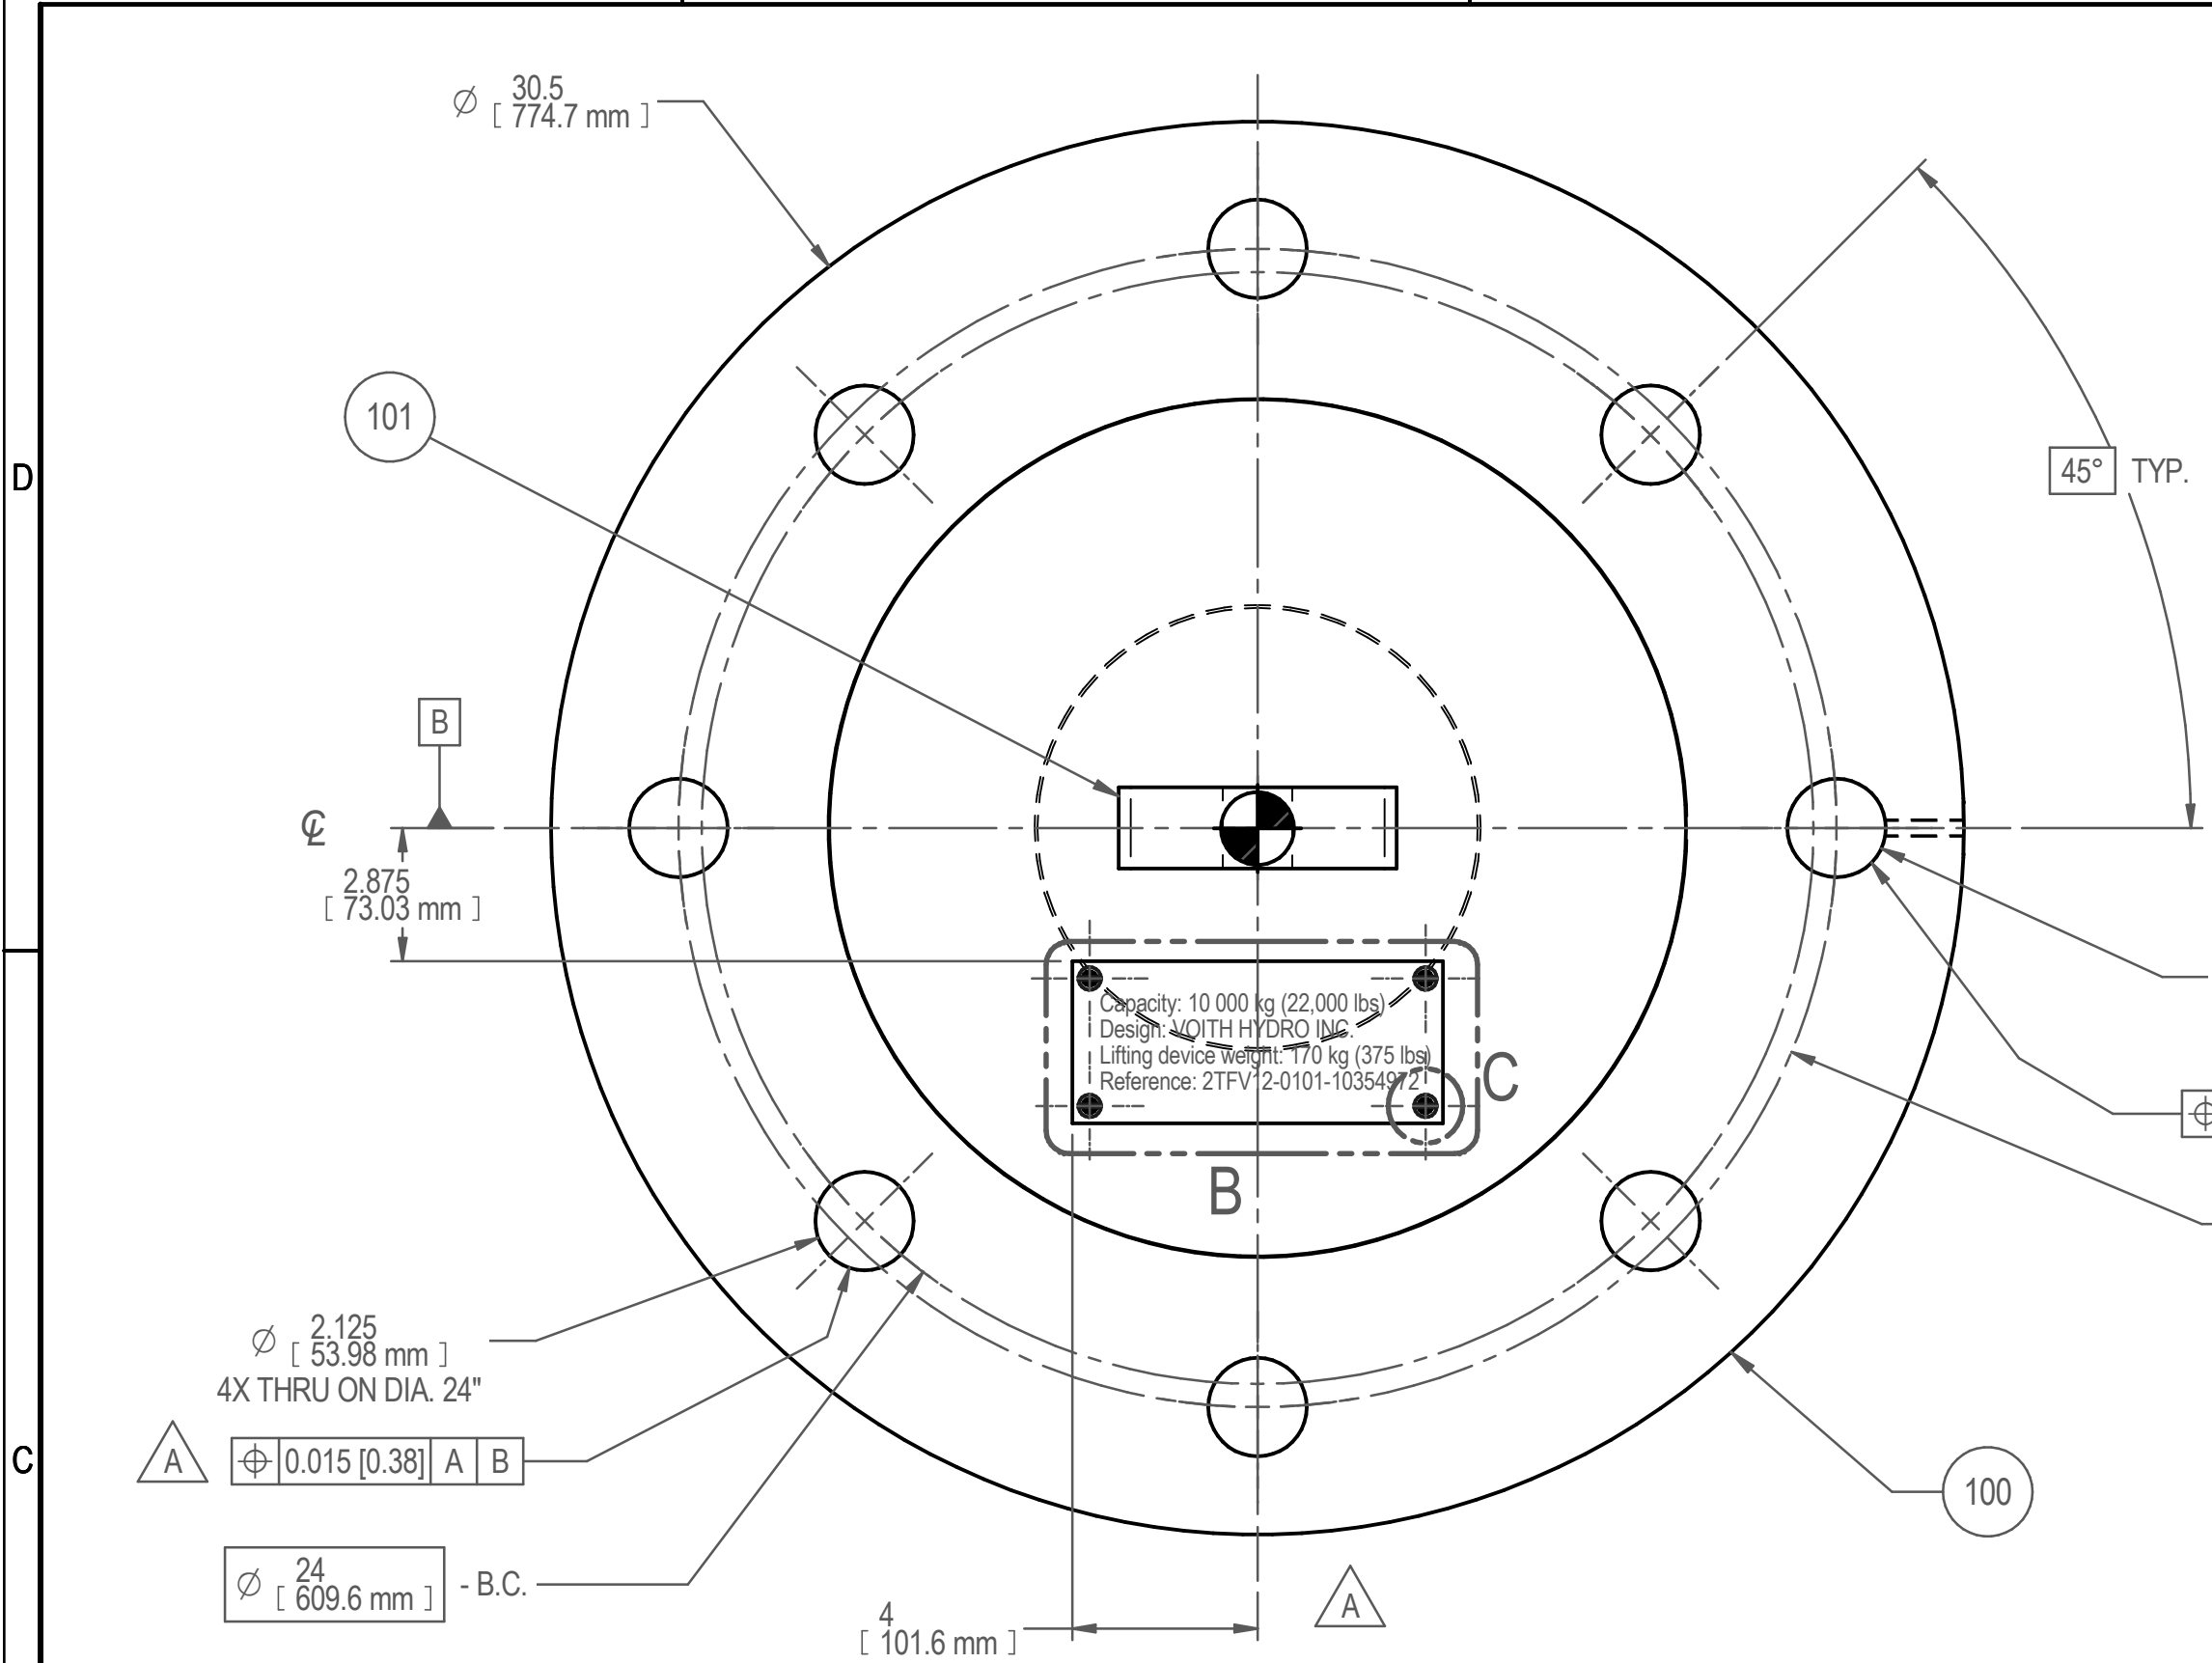


PLAN VIEW

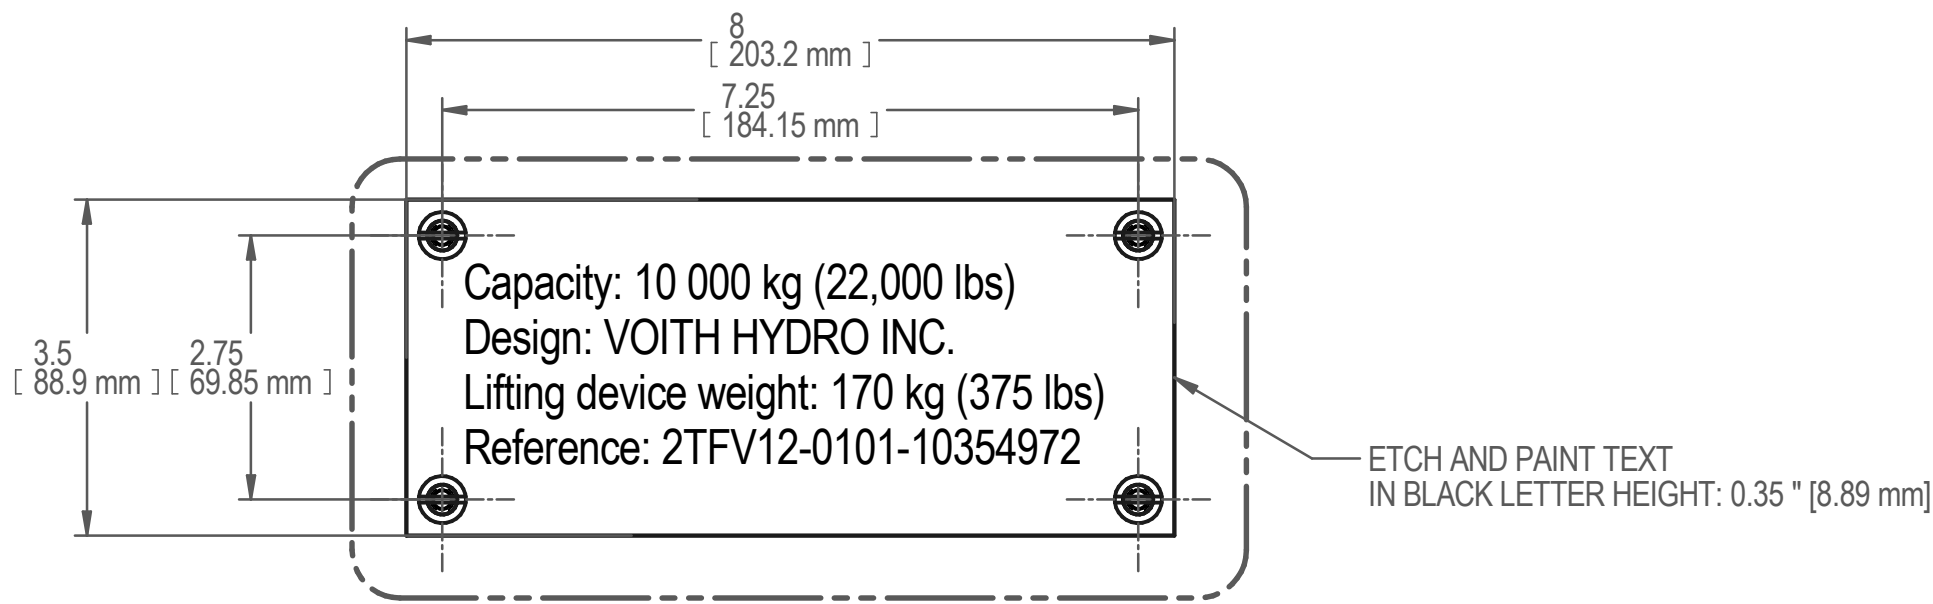


DETAIL B

1:2

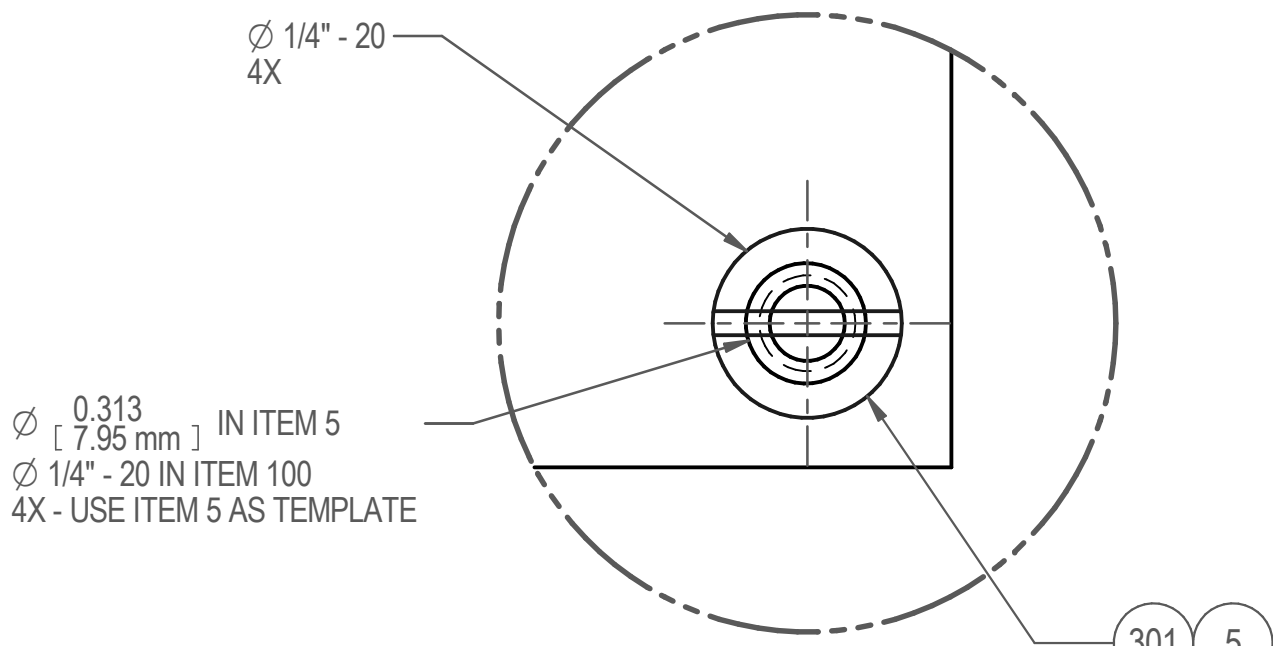


DETAIL C


2:1

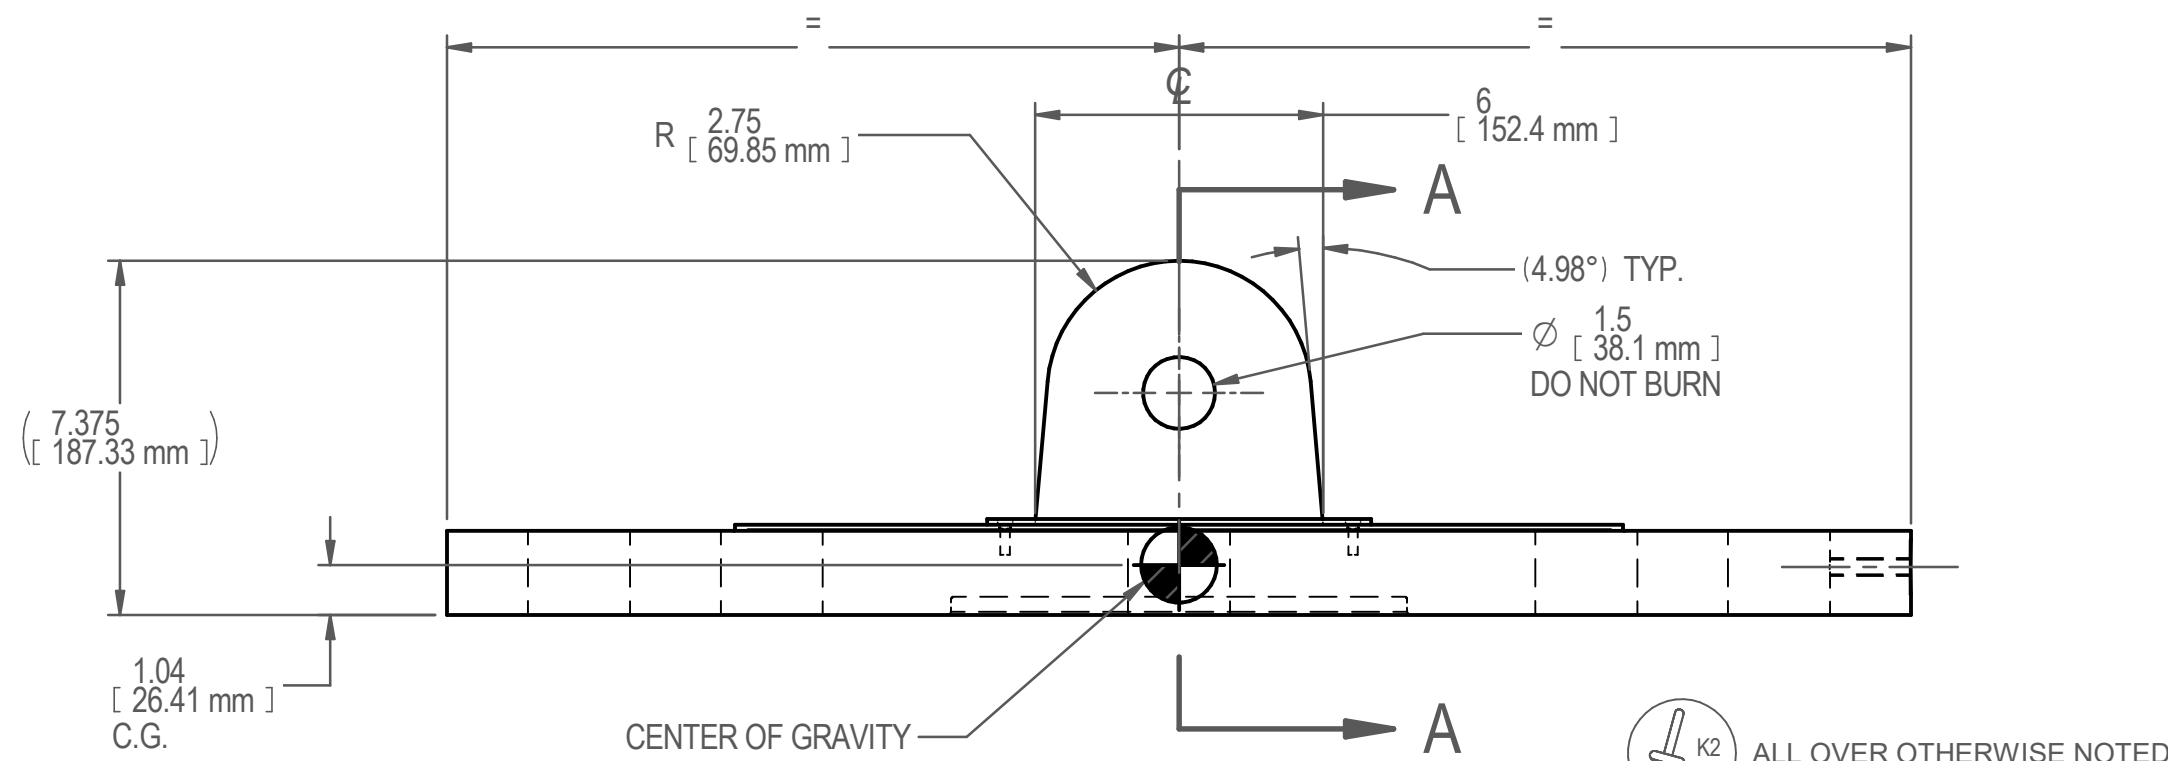

ITEM 1

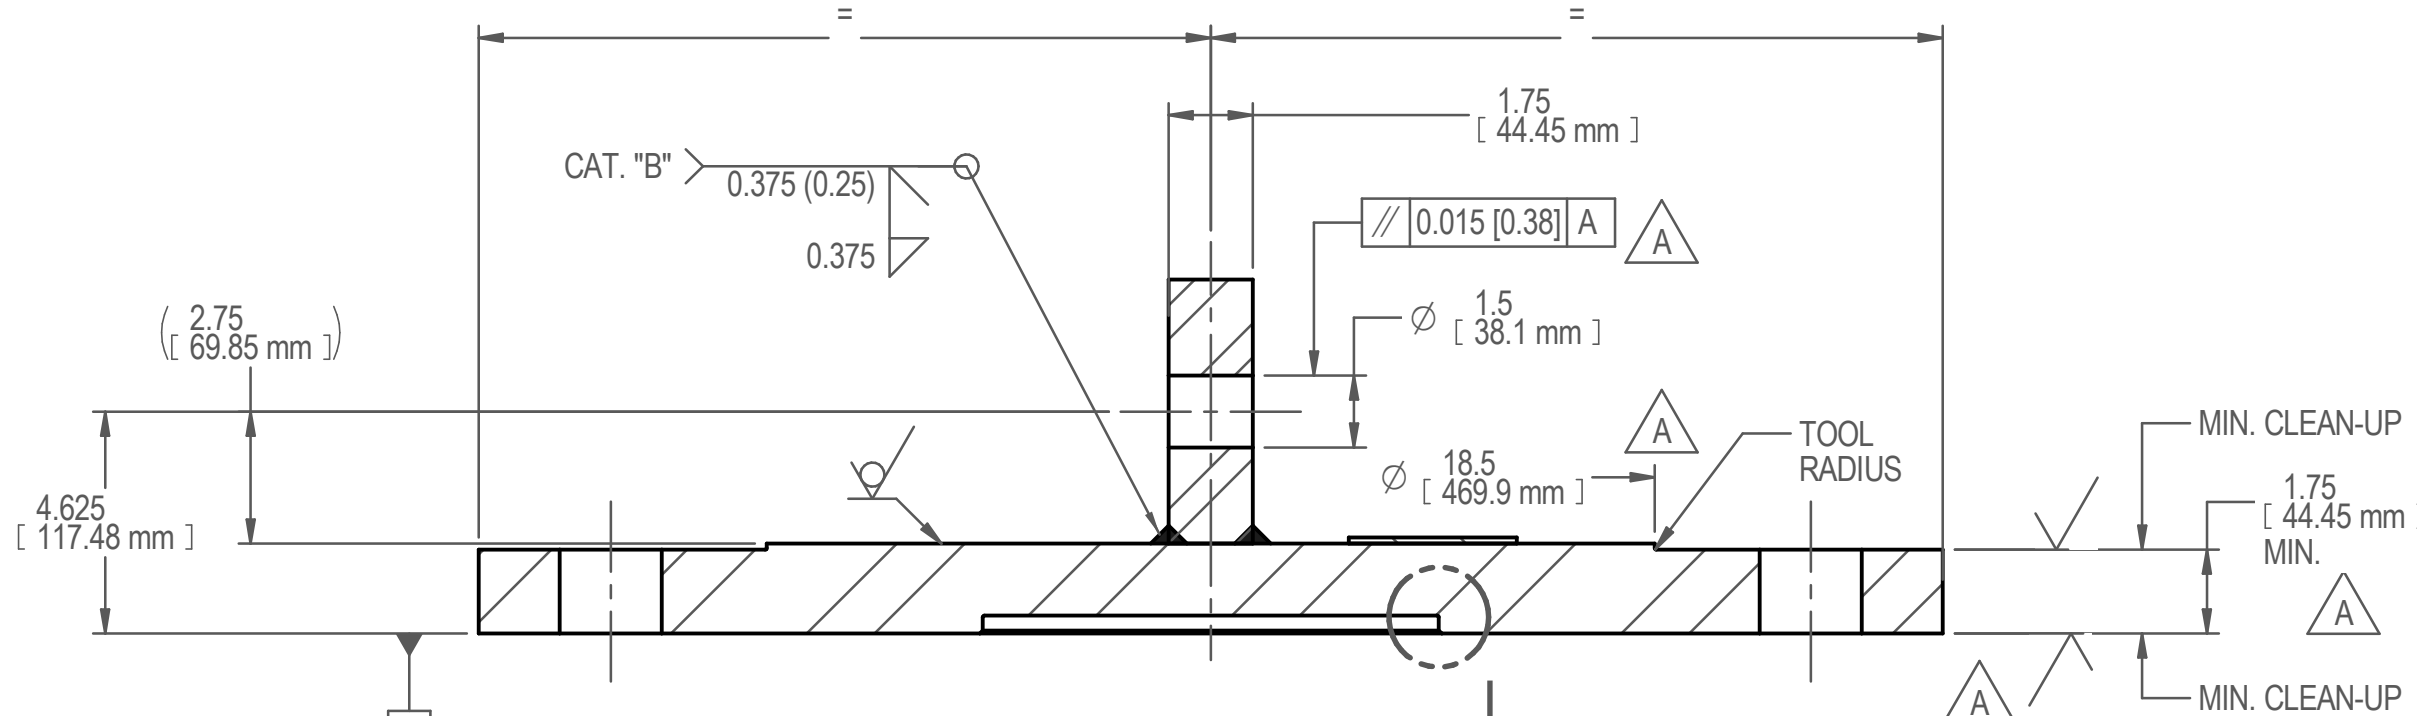

SECTION A-A

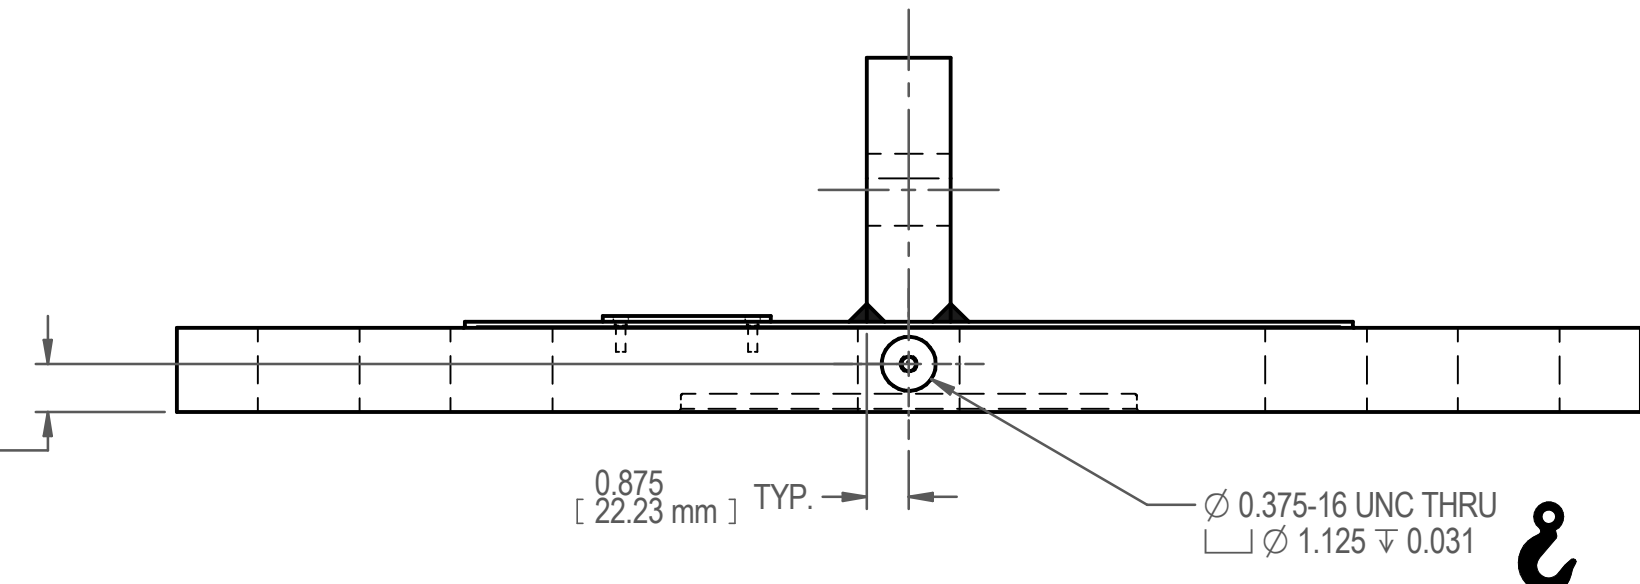

DETAIL L

1:1

transalta

LEGEND:

- ITEM NO. OF THE PART LIST (ASSEMBLY OR SUB-ASSEMBLY)
- ITEM NUMBER OF THE PART LIST (PART)
- REFERENCE ID. OF THE REFERENCE LIST
- REFERENCE ID. ITEM NO. OF THE PART
- NOTE NO.

HIGHER ASSEMBLY: VHM# -
TRANSALTA# -

NOTES:

- SEE GENERAL TOLERANCES TABLE BELOW FOR GENERAL NOTES.
- WELDS ACCORDING TO REF. "A". EXAMINATION AS PER CATEGORY "D" UNLESS OTHERWISE SPECIFIED.
- ALL FULL PENETRATION WELDS NOT INDICATED BUT REQUIRED TO FABRICATE A PLATE MUST BE EXAMINED AS PER CATEGORY "B" UNLESS OTHERWISE STATED.
- BRACKETS [] INDICATE DIMENSIONS IN MILLIMETERS.
- DIMENSIONS ARE FOR FINAL PRODUCT. THE MANUFACTURER MUST CONSIDER SHRINKING ALLOWANCE.
- MACHINED SURFACES TO BE 250 Ra [6.3] UNLESS OTHERWISE STATED. CUT SURFACES TO BE 500 Ra [12.5].
- BREAK ALL SHARP EDGES.
- SURFACE PAINTING, PROTECTION OR PREPARATION AS PER REF. "B".

ALL DRILLED AND TAPPED HOLES, SPOTFACES AND MACHINED SURFACES AS INDICATED ON DRAWING.

AS SHOWN ON DRAWING

- PACKING, SHIPPING, HANDLING AND STORAGE AS PER REF. "C".
- FULL INSPECTION REPORT AS PER REF. "D".
- LOAD TEST THE DEVICE IN SHOP AT 125% OF RATED CAPACITY TO SIMULATE TRUE LOADING CONDITIONS.

RATED CAPACITY: 22,000 lbs (10,000 kg)

- ALL LIFTING DEVICES AS PER ASME BTH-1 DESIGN CATEGORY A, SERVICE CLASS 0.
- WHEN LIFTING, ALWAYS ENSURE LOAD REMAINS LEVEL UPON LEAVING THE GROUND. RECENTER THE LIFTING DEVICE IF NECESSARY.

J	SHAFT COUPLING RUNNER ASSEMBLY	2TFV02-0221-10355074	1660-E1-MN-10052
H	SHAFT COUPLING RUNNER-DETAILS	2TFV02-0221-10355075	1660-E1-MN-10053
F	RUNNER	2TFV01-0101-10354937	1660-E1-MN-10051
E	POWER UNIT GENERAL SUPPLY QUALITY SPECIFICATION	2PPE05-0201-10369594	1660-E1-MN-10047
D	LIFTING DEVICE FABRICATION ITP	2TFV12-0101-10354973	-
C	PACKING SHIPPING HANDLING & STORAGE SPECIFICATION	2TFV00-0000-10393958	-
B	PAINT AND PROTECTION SPECIFICATION	2TFV00-0000-10355002	-
A	WELDING AND NDT SPECIFICATION	2TFV00-0000-10354942	-

ID.	REFERENCES LIST	VOITH DOC. NO.	TRANSALTA DOC. NO.
-----	-----------------	----------------	--------------------

RECORD DRAWING	CURRENT REVISION SEALED BY		VOITH UNIT No.	CLIENT GROUP No.
	ENGINEERING SEAL (APEG) VOITH CERTIFICATE - APEGA #18237	ENGINEERING SEAL (IQI)	01	U1
PREVIOUS REVISION SEALED BY		PREVIOUS REVISION SEALED BY	NOT APPLICABLE	










Project Name			Sales Order	2010726	Material Master	620.585274
CASCADE UNIT 1			Scale of original	1:4	Weight	490 lbs
			Title			
Dimensions in INCHES			LIFTING DEVICE			
ASME Y14 100			RUNNER & SHAFT			
Size ASME Y14.5						
Release note			Drawing number		Rev.	Sheet
			2TFV12-0101-10354972		B	1
VOITH			Drawing type		of Sheets	
			FABRICATION DRAWING		3	
TRANSALTA DRAWING NUMBER			1660-E1-MN-10034			


Rev	Qty	Date	Appr	Copyright
C-1	0.015	WAS	0.002	
C-4	0.015	WAS	0.004	
B-3	0.015	WAS	0.004	
C-2	DATUM "C" REMOVED			
A-1	FLATNESS 0.015 ADDED			
A-4	ANNOTATION ADDED			
A-3	FINISH SURFACE ADDED			
A-5	DIM ADDED			
A-6	DETAIL "L" ADDED			
A-7	DETAIL "L" ADDED			
A-8	DETAIL "L" ADDED			
A-100	DETAIL "L" ADDED			

Rev	Qty	Date	Appr	Copyright
C-1	0.015	WAS	0.002	
C-4	0.015	WAS	0.004	
B-3	0.015	WAS	0.004	
C-2	DATUM "C" REMOVED			
A-1	FLATNESS 0.015 ADDED			
A-4	ANNOTATION ADDED			
A-3	FINISH SURFACE ADDED			
A-5	DIM ADDED			
A-6	DETAIL "L" ADDED			
A-7	DETAIL "L" ADDED			
A-8	DETAIL "L" ADDED			
A-100	DETAIL "L" ADDED			

Rev	Qty	Date	Appr	Copyright
C-1	0.015	WAS	0.002	
C-4	0.015	WAS	0.004	
B-3	0.015	WAS	0.004	
C-2	DATUM "C" REMOVED			
A-1	FLATNESS 0.015 ADDED			
A-4	ANNOTATION ADDED			
A-3	FINISH SURFACE ADDED			
A-5	DIM ADDED			
A-6	DETAIL "L" ADDED			
A-7	DETAIL "L" ADDED			
A-8	DETAIL "L" ADDED			
A-43	DETAIL "L" ADDED			

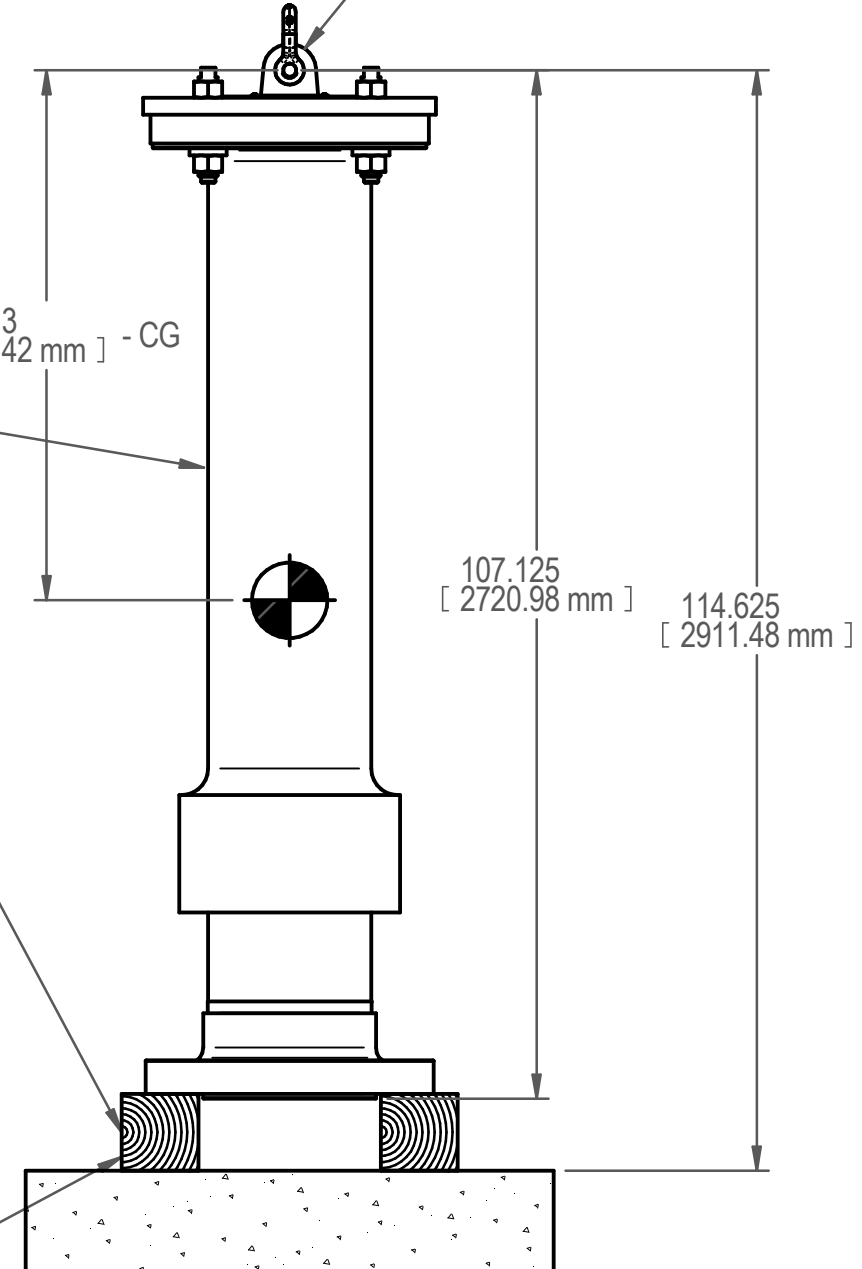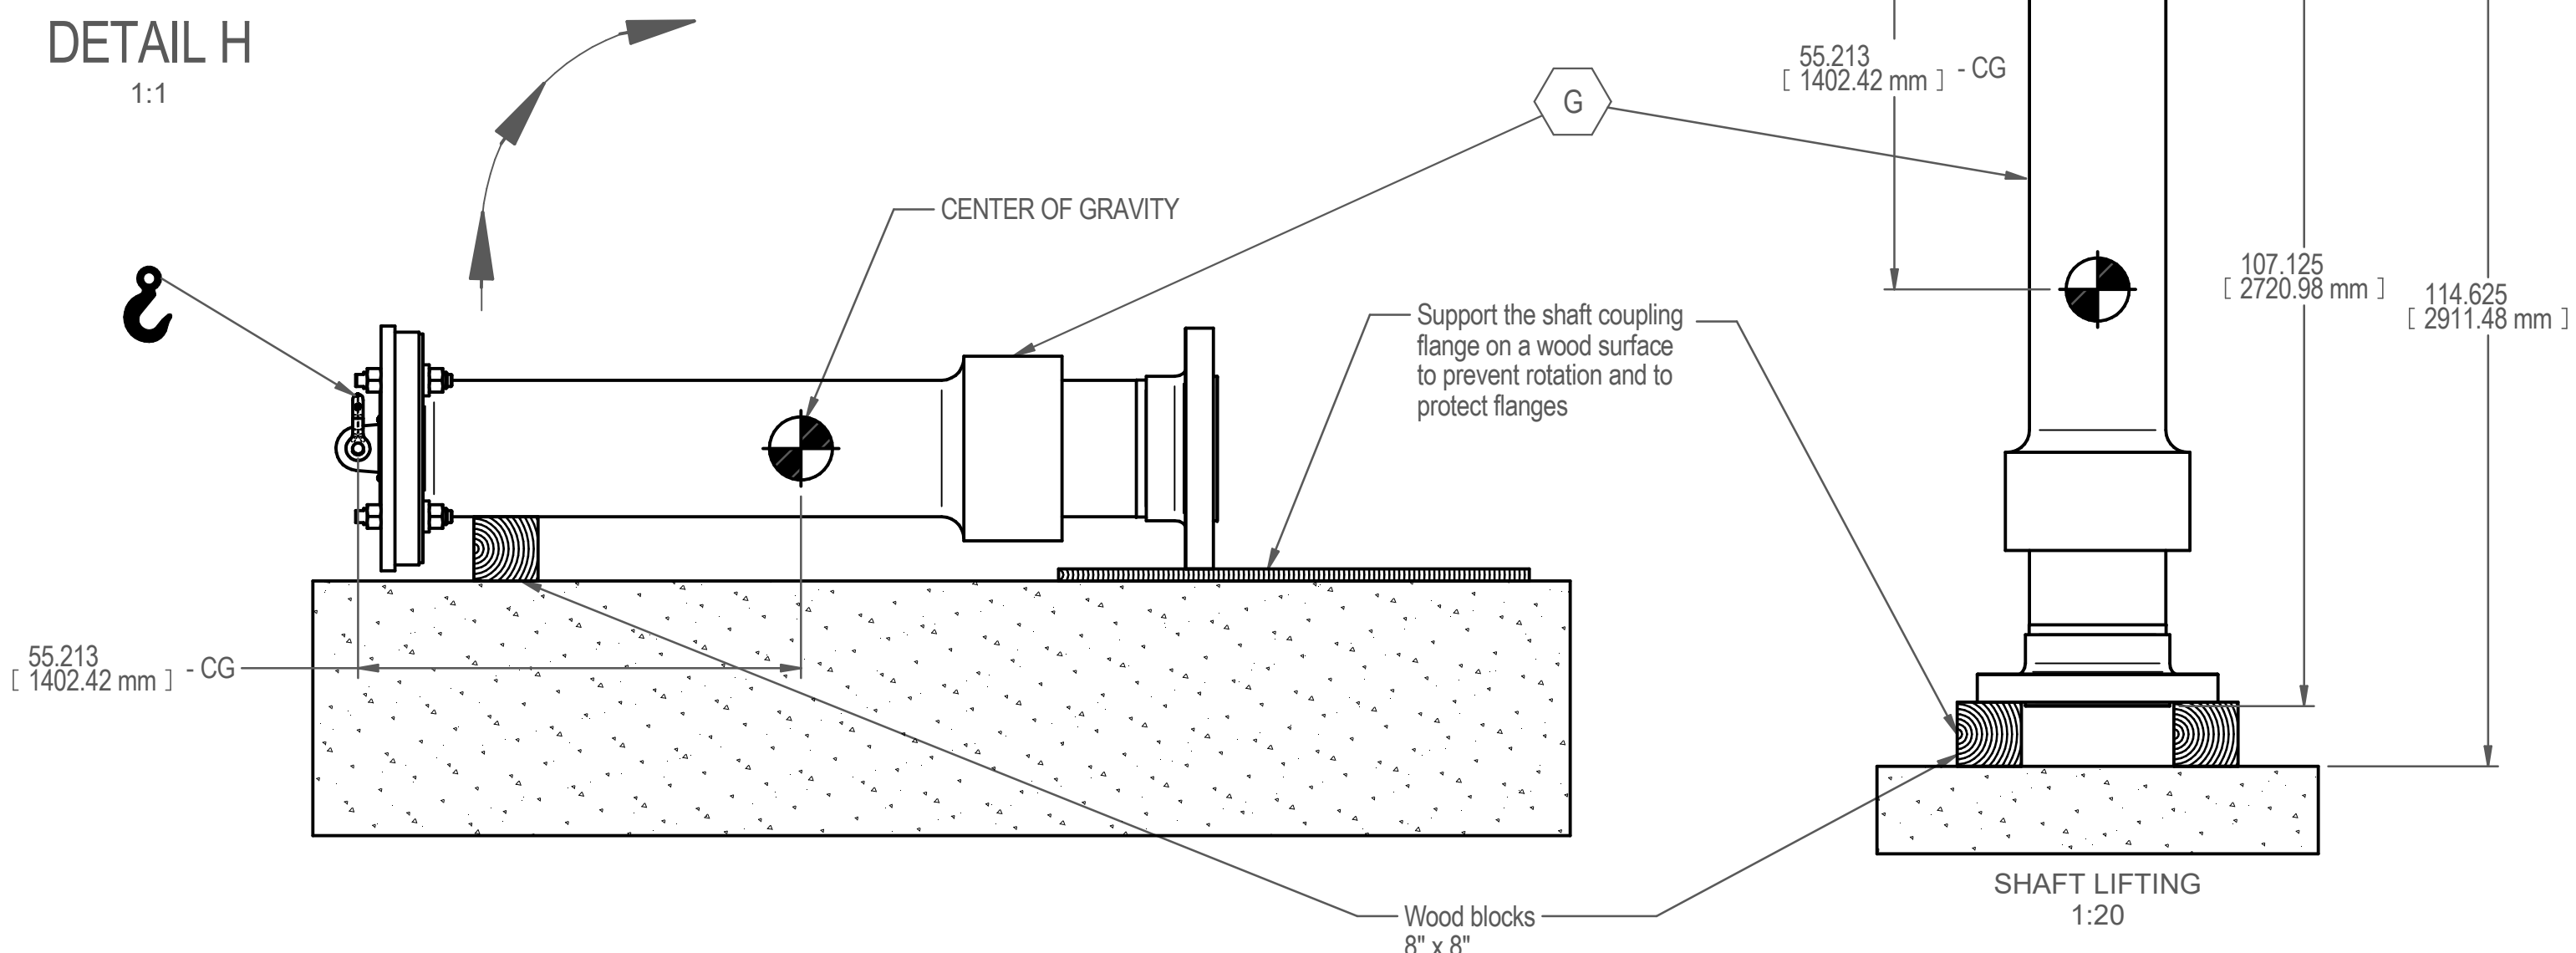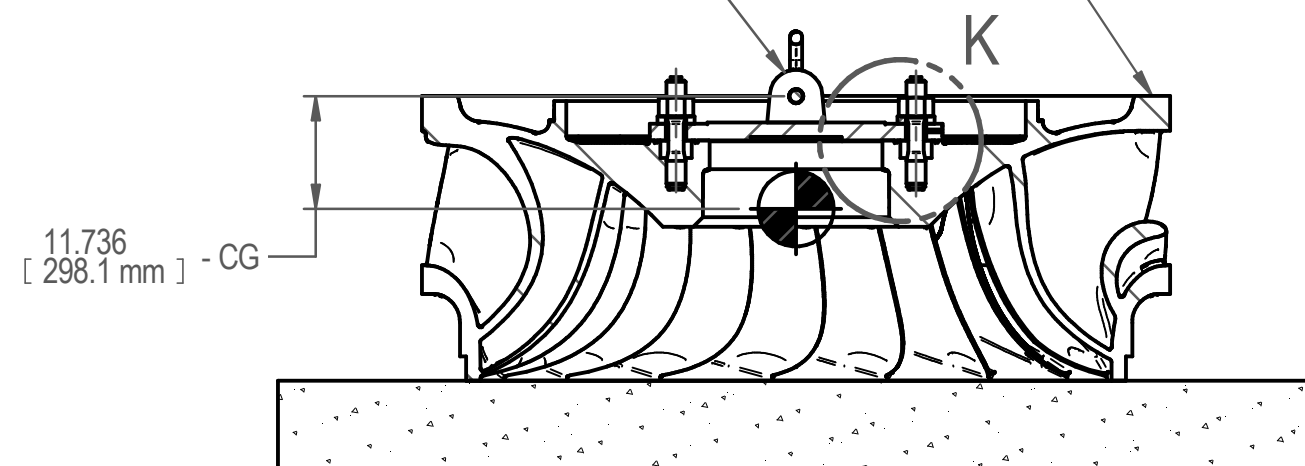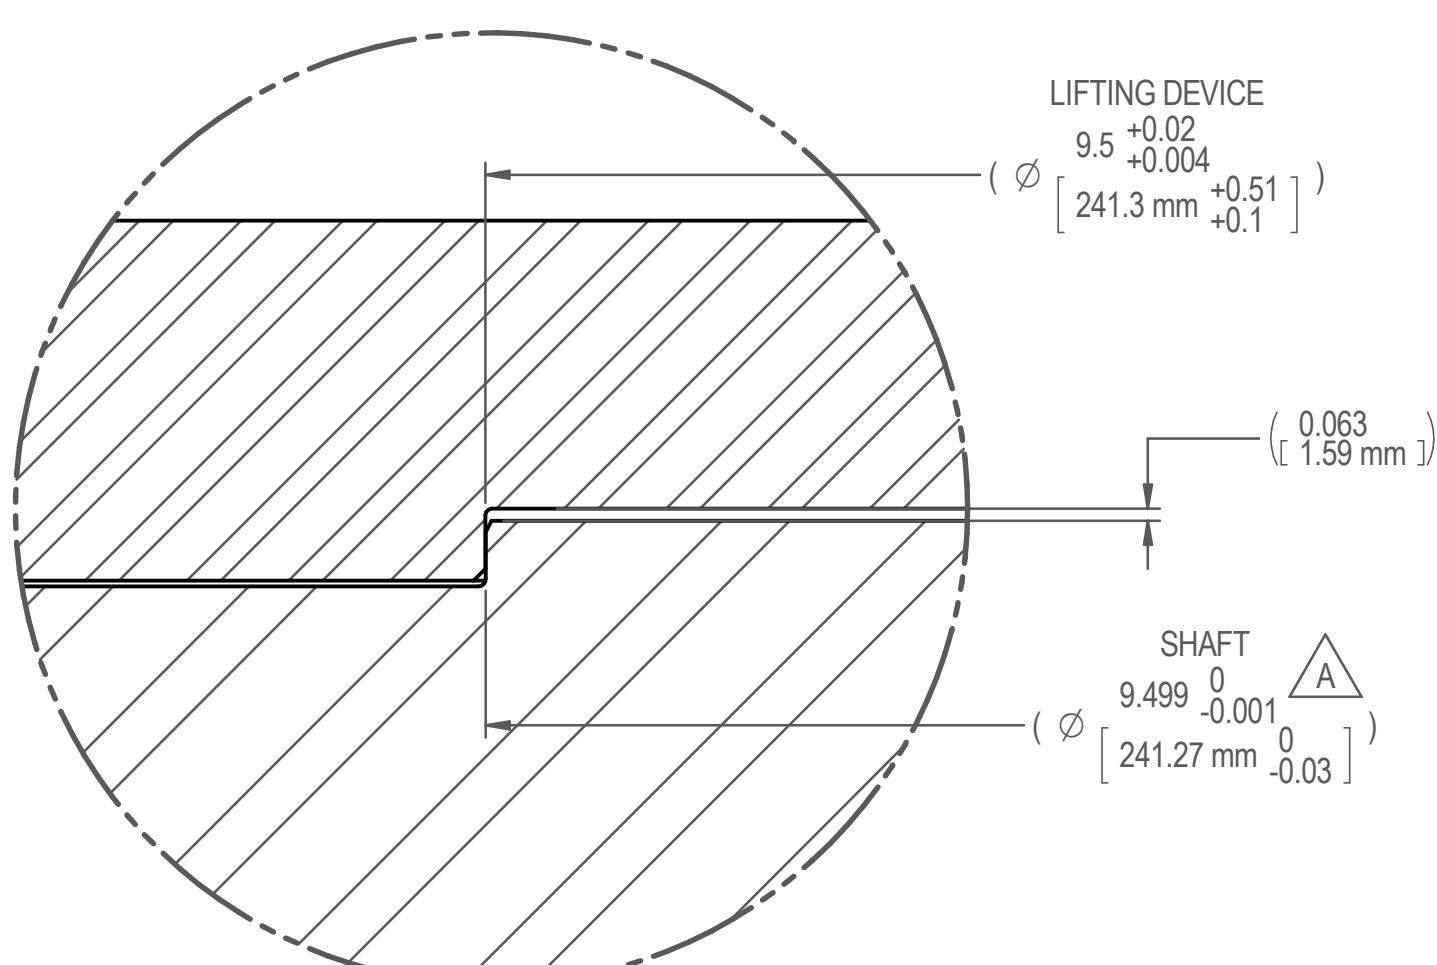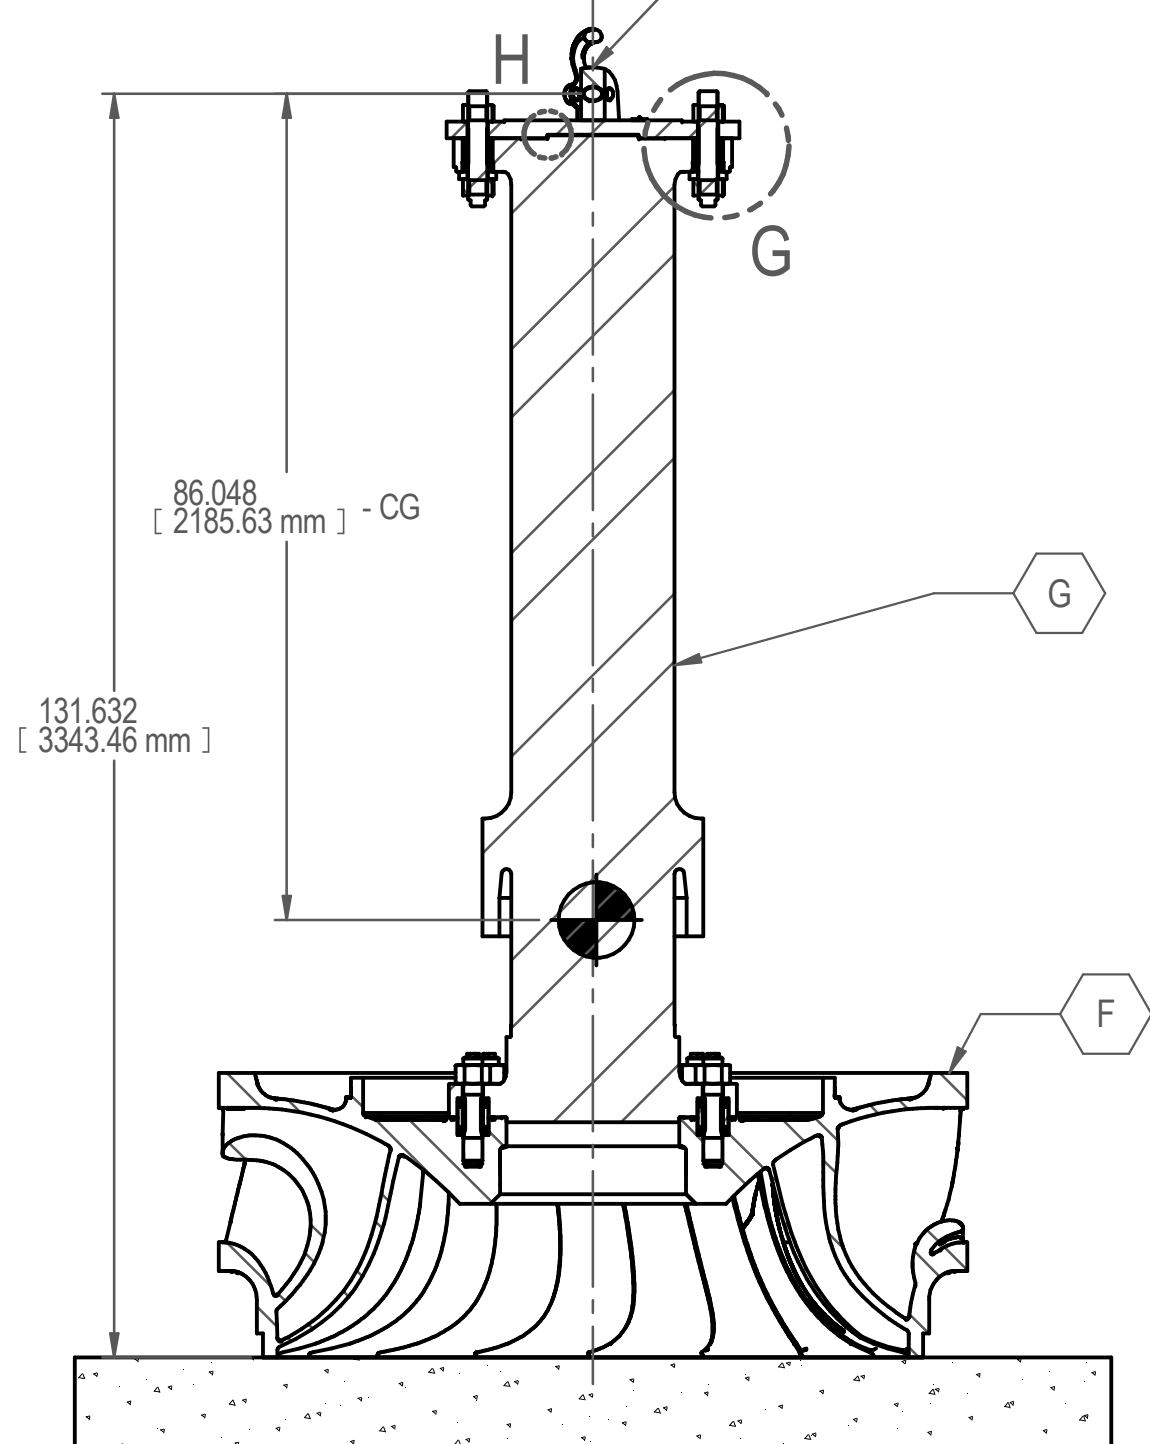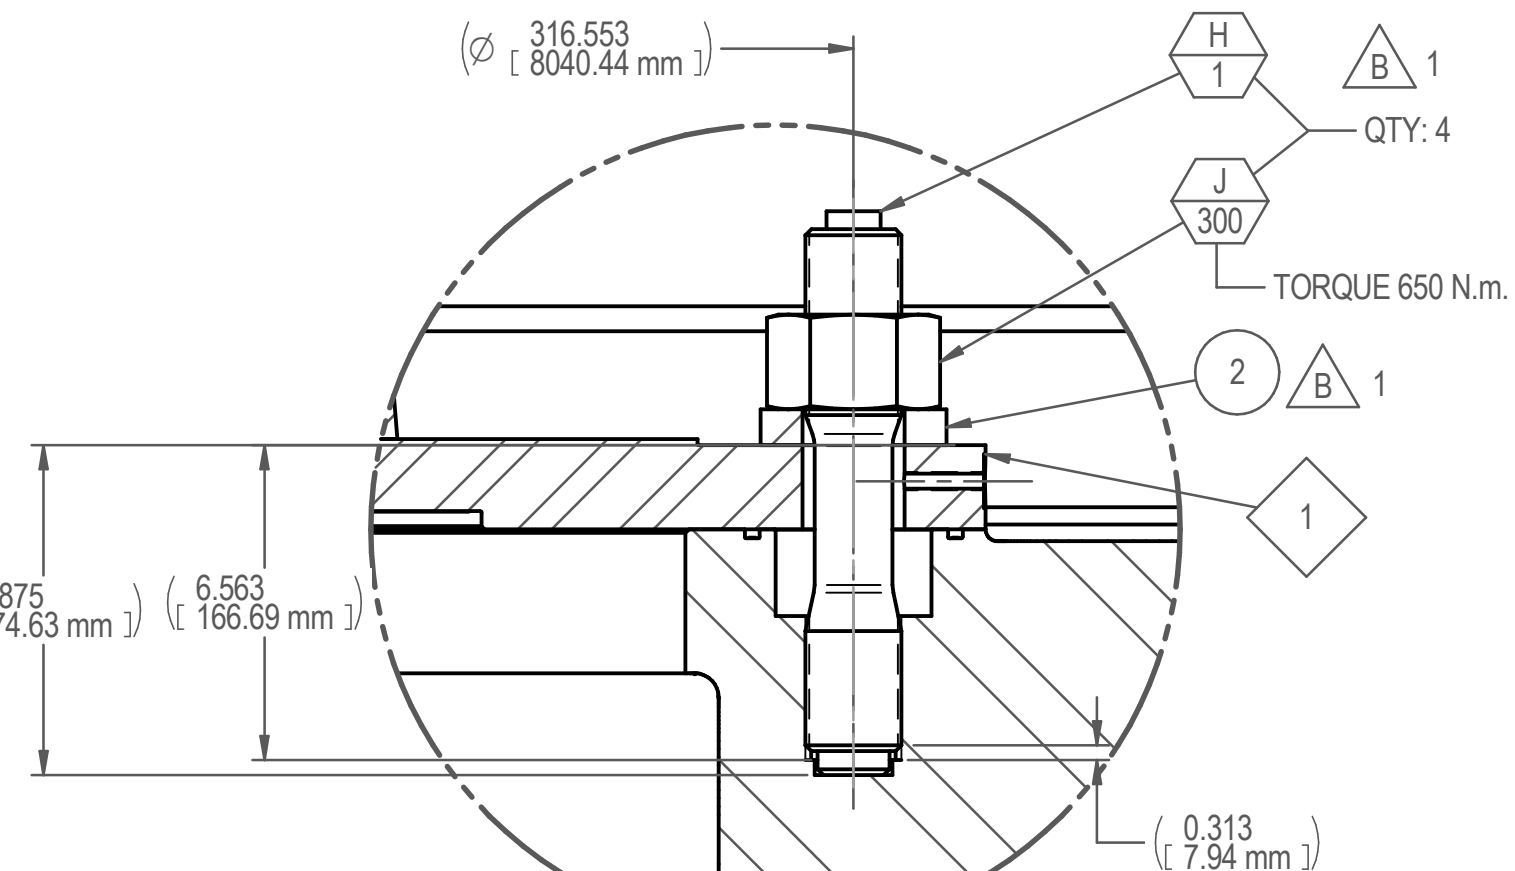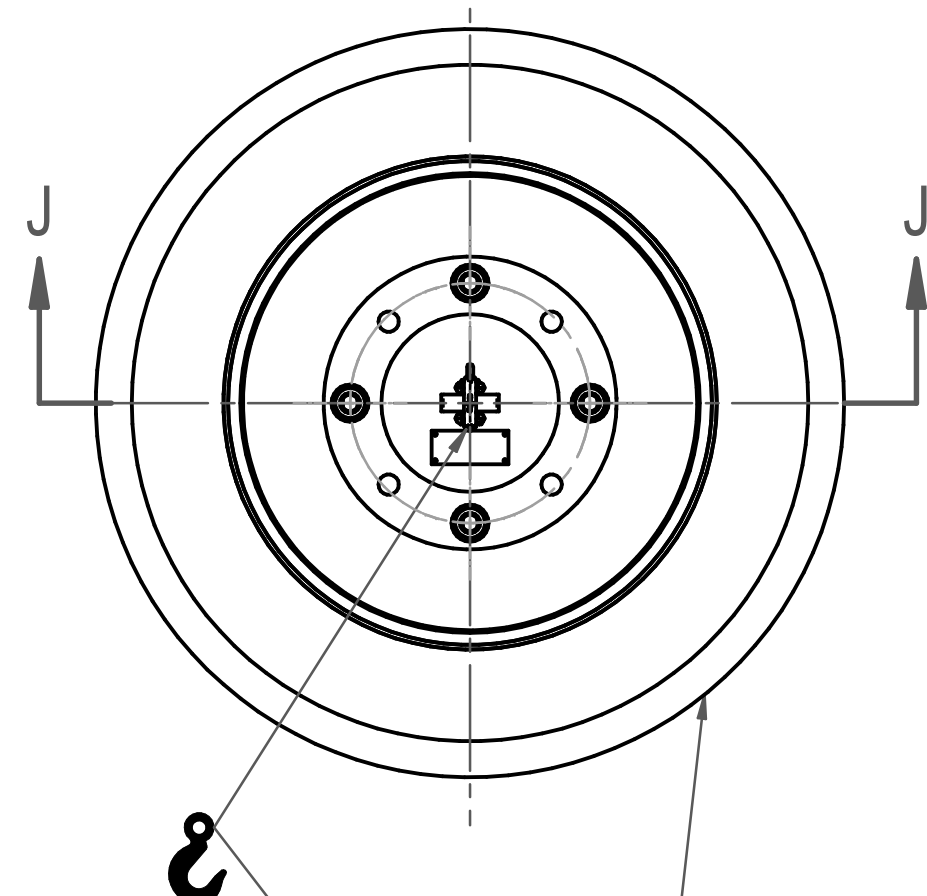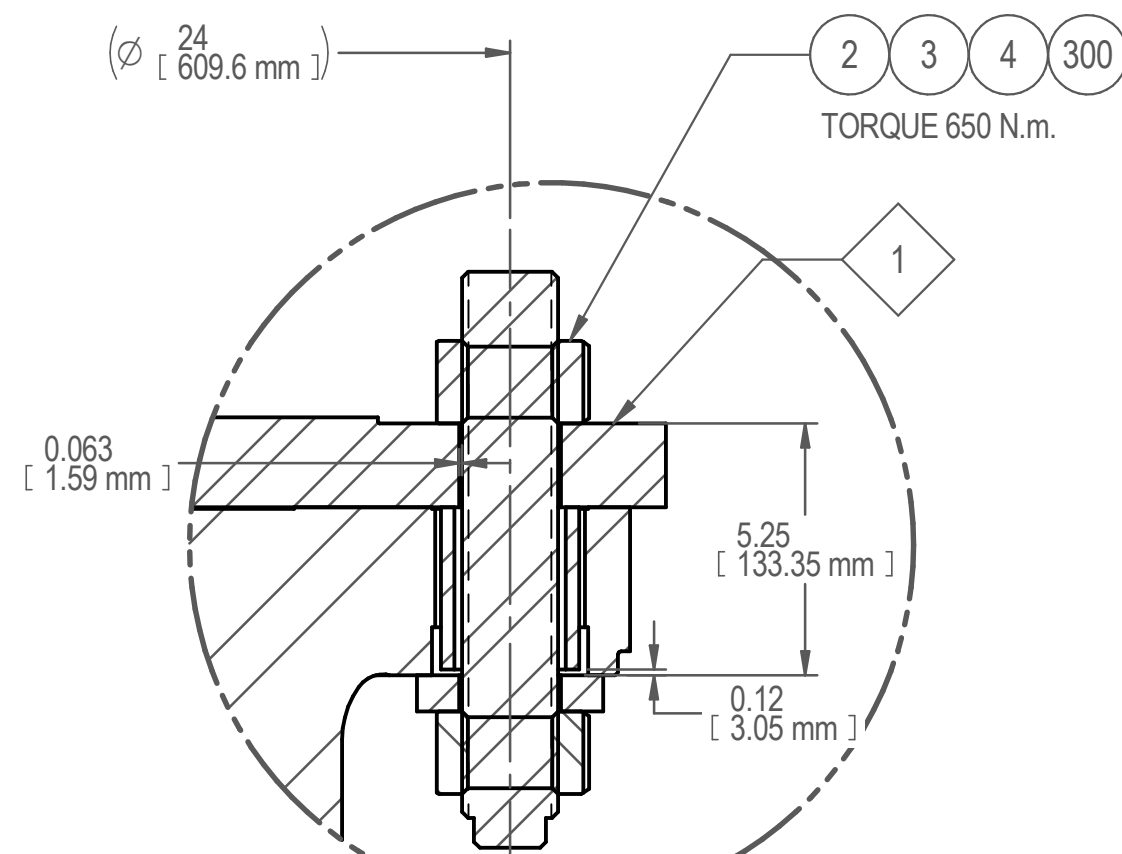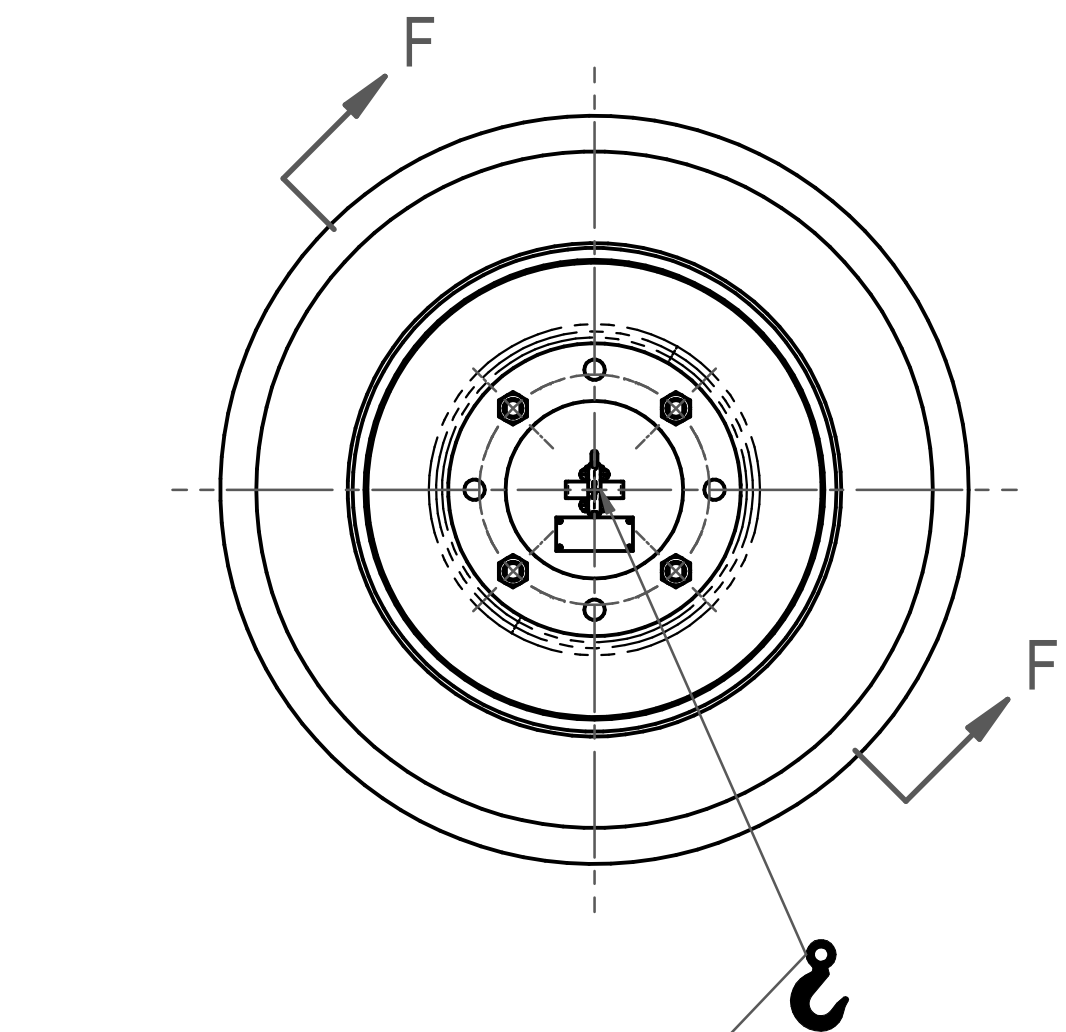

**transalta™**

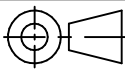
RECORD DRAWING	CURRENT REVISION SEALED BY				VOITH UNIT No.	CLIENT GROUP No.
	ENGINEERING SEAL (APEG) VOITH CERTIFICATE - APEGA #16237		ENGINEERING SEAL (OIQ)		01	U1
		PREVIOUS REVISION SEALED BY		PREVIOUS REVISION SEALED BY		 NOT APPLICABLE
Project Name			Sales Order		Material Master	
CASCADE UNIT 1			2010726		620.585274	
			Scale of original		Weight	
			1:20		490 lbs	
			Title		LIFTING DEVICE RUNNER & SHAFT	
Dimensions in INCHES ASME Y14.100 Size ASME Y14.5			Date 2023-10-30 Name RIVESA			
Chk. 2024-02-06 AUGERN			Apr. 2024-02-06 POULIOB			
2nd. App. -			-			
Release note F VOITH			Drawing number 2TFV12-0101-10354972		Rev. B	
			Drawing type FABRICATION DRAWING		Sheet 1 of Sheets 3	
TRANSALTA DRAWING NUMBER			1660-E1-MN-10034			

		Revisions	
Rev	Qty./Date/ App. Copyright	Loc.	
A	TOL WAS -0.002 / 0.003 4/15/2024	B-4 POULB	
	RECORD DRAWING, AUTHENTICATOR DISCLAIMER AND "TransAlta" DRAWING NUMBER UPDATED		
B	REF "H" AND "J" WAS IT. 4 AND 300 IT. 2: PICTORIAL ADDED DETAIL "K" REVISED	D-8 C-7 POULB	
	5/7/2025	FPLQ	

RECORD DRAWING

The signature of the undersigned on this record drawing certifies that the design information accurately reflects the original design and the material design changes made during construction that were brought to the undersigned's attention. These record drawings are intended to incorporate change orders and other material design changes, but not necessarily all site instructions. The undersigned does not warrant or guarantee, nor accept any responsibility for the accuracy or completeness of the record information supplied by others contained in these drawings, but does, by signing, certify that the record information, if accurate and complete, provides an as constructed system which substantially complies with all material respects with the original design intent.

GENERAL TOLERANCES FOR WELDED PARTS AS PER ISO 13920:1996.				
CLASSES B & F (CONVERTED TO INCHES)				
DIMENSION (ROUNDED)	0.08	1.2		
LINEAR	+ 0.04	0.08	- 0.48	- 16
GEOMETRIC		0.04	0.06	0.12
		0.12	0.12	0.40
		0.18	0.16	0.80
		0.24	0.24	1.60
		0.32	0.32	
LENGTH "L" (ROUNDED)	0		16	40
ANGULAR "α"	+ 0.75°		0.5°	0.33°

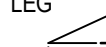GENERAL TOLERANCES FOR MACHINE PARTS CLASSES m & k AND DIN 7168:1991, CLASS 12											
DIMENSION (ROUNDED)		0.02		0.12		0.24		0.48		0.96	
LINEAR		+	0.008	0.004	0.002	0.001	0.0005	0.00025	0.000125	0.0000625	0.00003125
BROKEN EDGES		+	0.008	0.004	0.002	0.001	0.0005	0.00025	0.000125	0.0000625	0.00003125
LENGTH "L" (ROUNDED)		0		0.4		2		12		60	
ANGULAR "α"		+	0.5°	0.33°	0.25°	0.17°	0.1°	0.05°	0.025°	0.0125°	0.00625°
											

SURFACES AS PER ISO 2768:1989, MESH M & T (CONVERTED TO INCHES)			
DIMENSION (ROUNDED)			
GEOMETRIC		0.002	0.4
		0.016	0.004 1.2
		0.024	0.008 4
		0.024	0.016 12
		0.031	0.024 40
		0.039	0.031 120
	0.039	0.039	0.047 160
	0.020	0.035	0.035 160

THIS DRAWING SHALL BE INTERPRETED
IN ACCORDANCE WITH ASME Y14.100.
ASME Y14.5 AND REFERRED STANDARDS.

THREADS PER ASME B1.1. THREAD
TOLERANCE CLASS 2A (EXT) / 2B (INT)

UNLESS OTHERWISE SPECIFIED, ALL
BOLTING PRESTRESS TORQUES ARE
FOR OIL LUBRICATED CONDITION.

ALL WELD SYMBOLS PER
AWS A2.4



SURFACE QUALITY Ra IN MICRONS PER
PER ASME B46.1 AND ASME Y14.36

CHAMFERS: 0.008 MIN
INSIDE RADI: 0.094 MAX
REAMING: +0.0015 / -0.0005